


DAVE & BUSTER'S

07 18 2024

DAVE & BUSTER'S WAUWATOSA, WI | EXTERIOR DESIGN FOR REVIEW BOARD

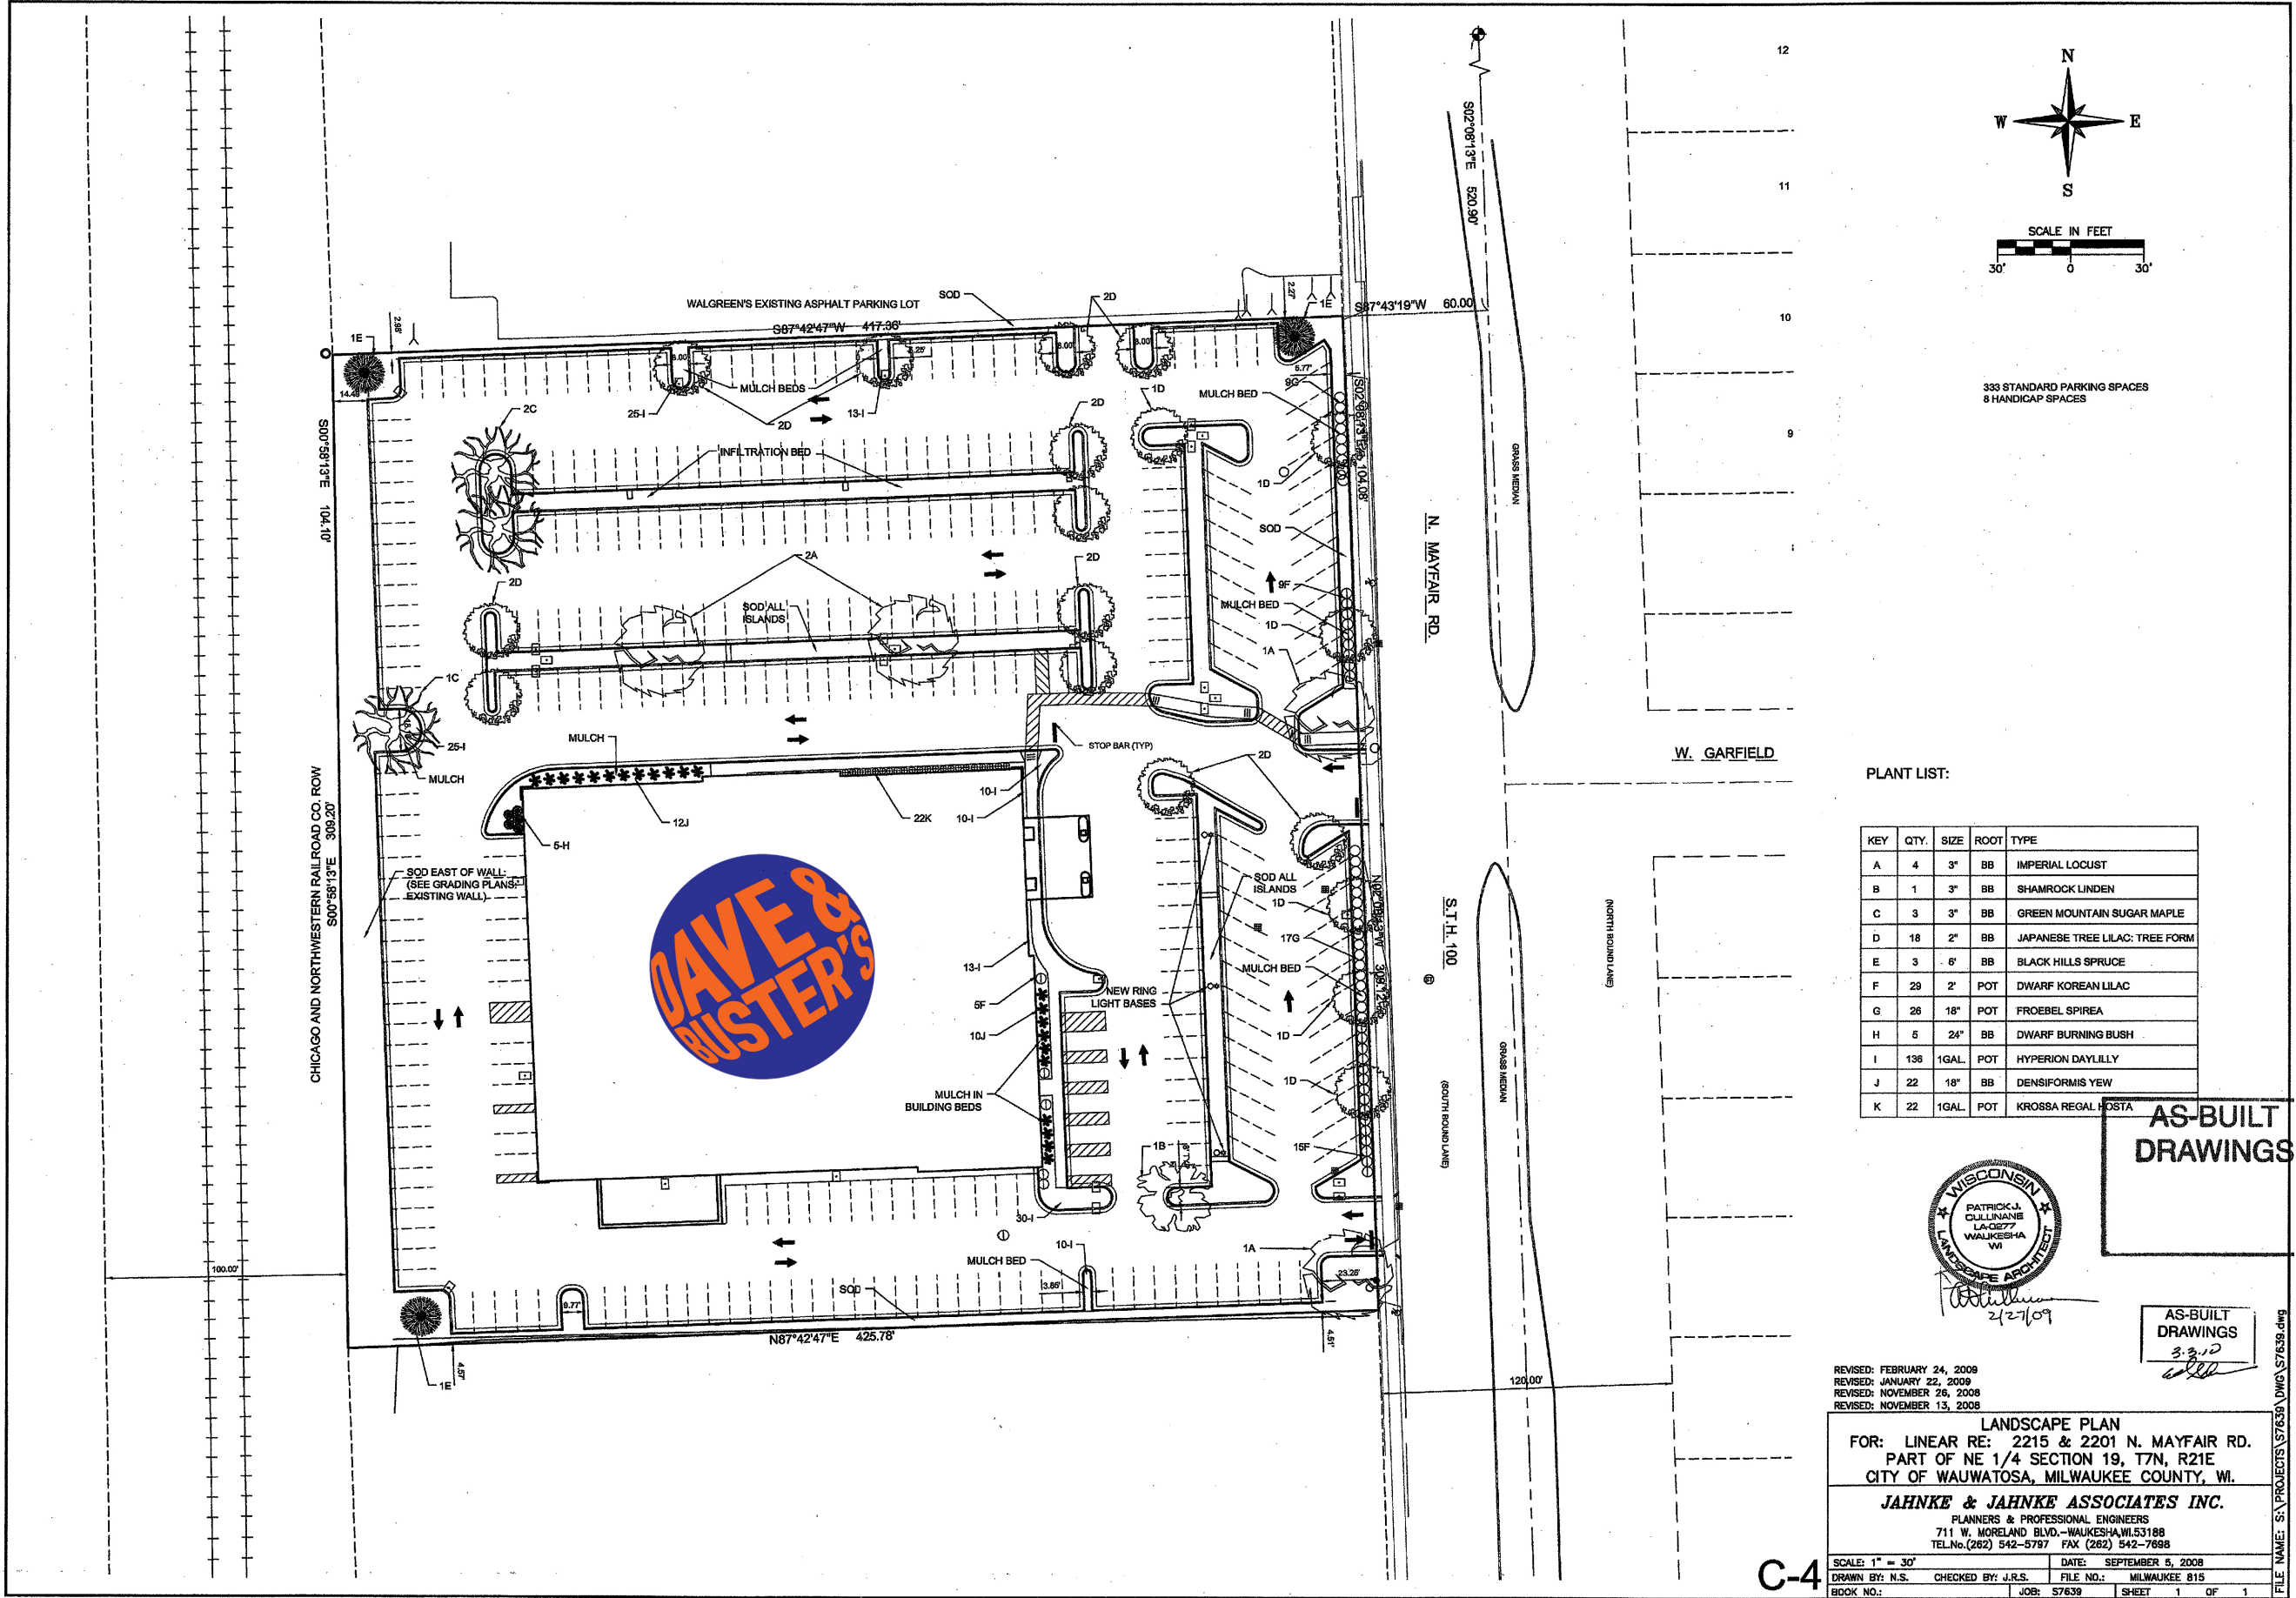

PLANT LIST:

KEY	QTY.	SIZE	ROOT	TYPE
A	4	3"	BB	IMPERIAL LOCUST
B	1	3"	BB	SHAMROCK LINDEN
C	3	3"	BB	GREEN MOUNTAIN SUGAR MAPLE
D	18	2"	BB	JAPANESE TREE LILAC; TREE FORM
E	3	6"	BB	BLACK HILLS SPRUCE
F	28	2"	POT	DWARF KOREAN LILAC
G	28	18"	POT	FROEBEL SPIREA
H	5	24"	BB	DWARF BURNING BUSH
I	136	1GAL.	POT	HYPERION DAYLILLY
J	22	18"	BB	DENSIFORMIS YEW
K	22	1GAL.	POT	KROSSA REGAL HOSTA

AS-BUILT
DRAWINGS



AS-BUILT
DRAWINGS
3.3.10
6/2/10


REVISED: FEBRUARY 24, 2008
REVISED: JANUARY 22, 2009
REVISED: NOVEMBER 26, 2008
REVISED: NOVEMBER 13, 2008

LANDSCAPE PLAN
FOR: LINEAR RE: 2215 & 2201 N. MAYFAIR RD.
PART OF NE 1/4 SECTION 19, T7N, R21E
CITY OF WAUWATOSA, MILWAUKEE COUNTY, WI.

JAHNKE & JAHNKE ASSOCIATES INC.
PLANNERS & PROFESSIONAL ENGINEERS
711 W. MORELAND BLVD.-WAUKESHA, WI. 53188
TEL. No. (262) 542-5797 FAX (262) 542-7698

SCALE: 1" = 30'
DRAWN BY: N.S. CHECKED BY: J.R.S. DATE: SEPTEMBER 5, 2008
BOOK NO.: FILE NO.: MILWAUKEE 815
JOB: 57639 SHEET 1 OF 1


C-4

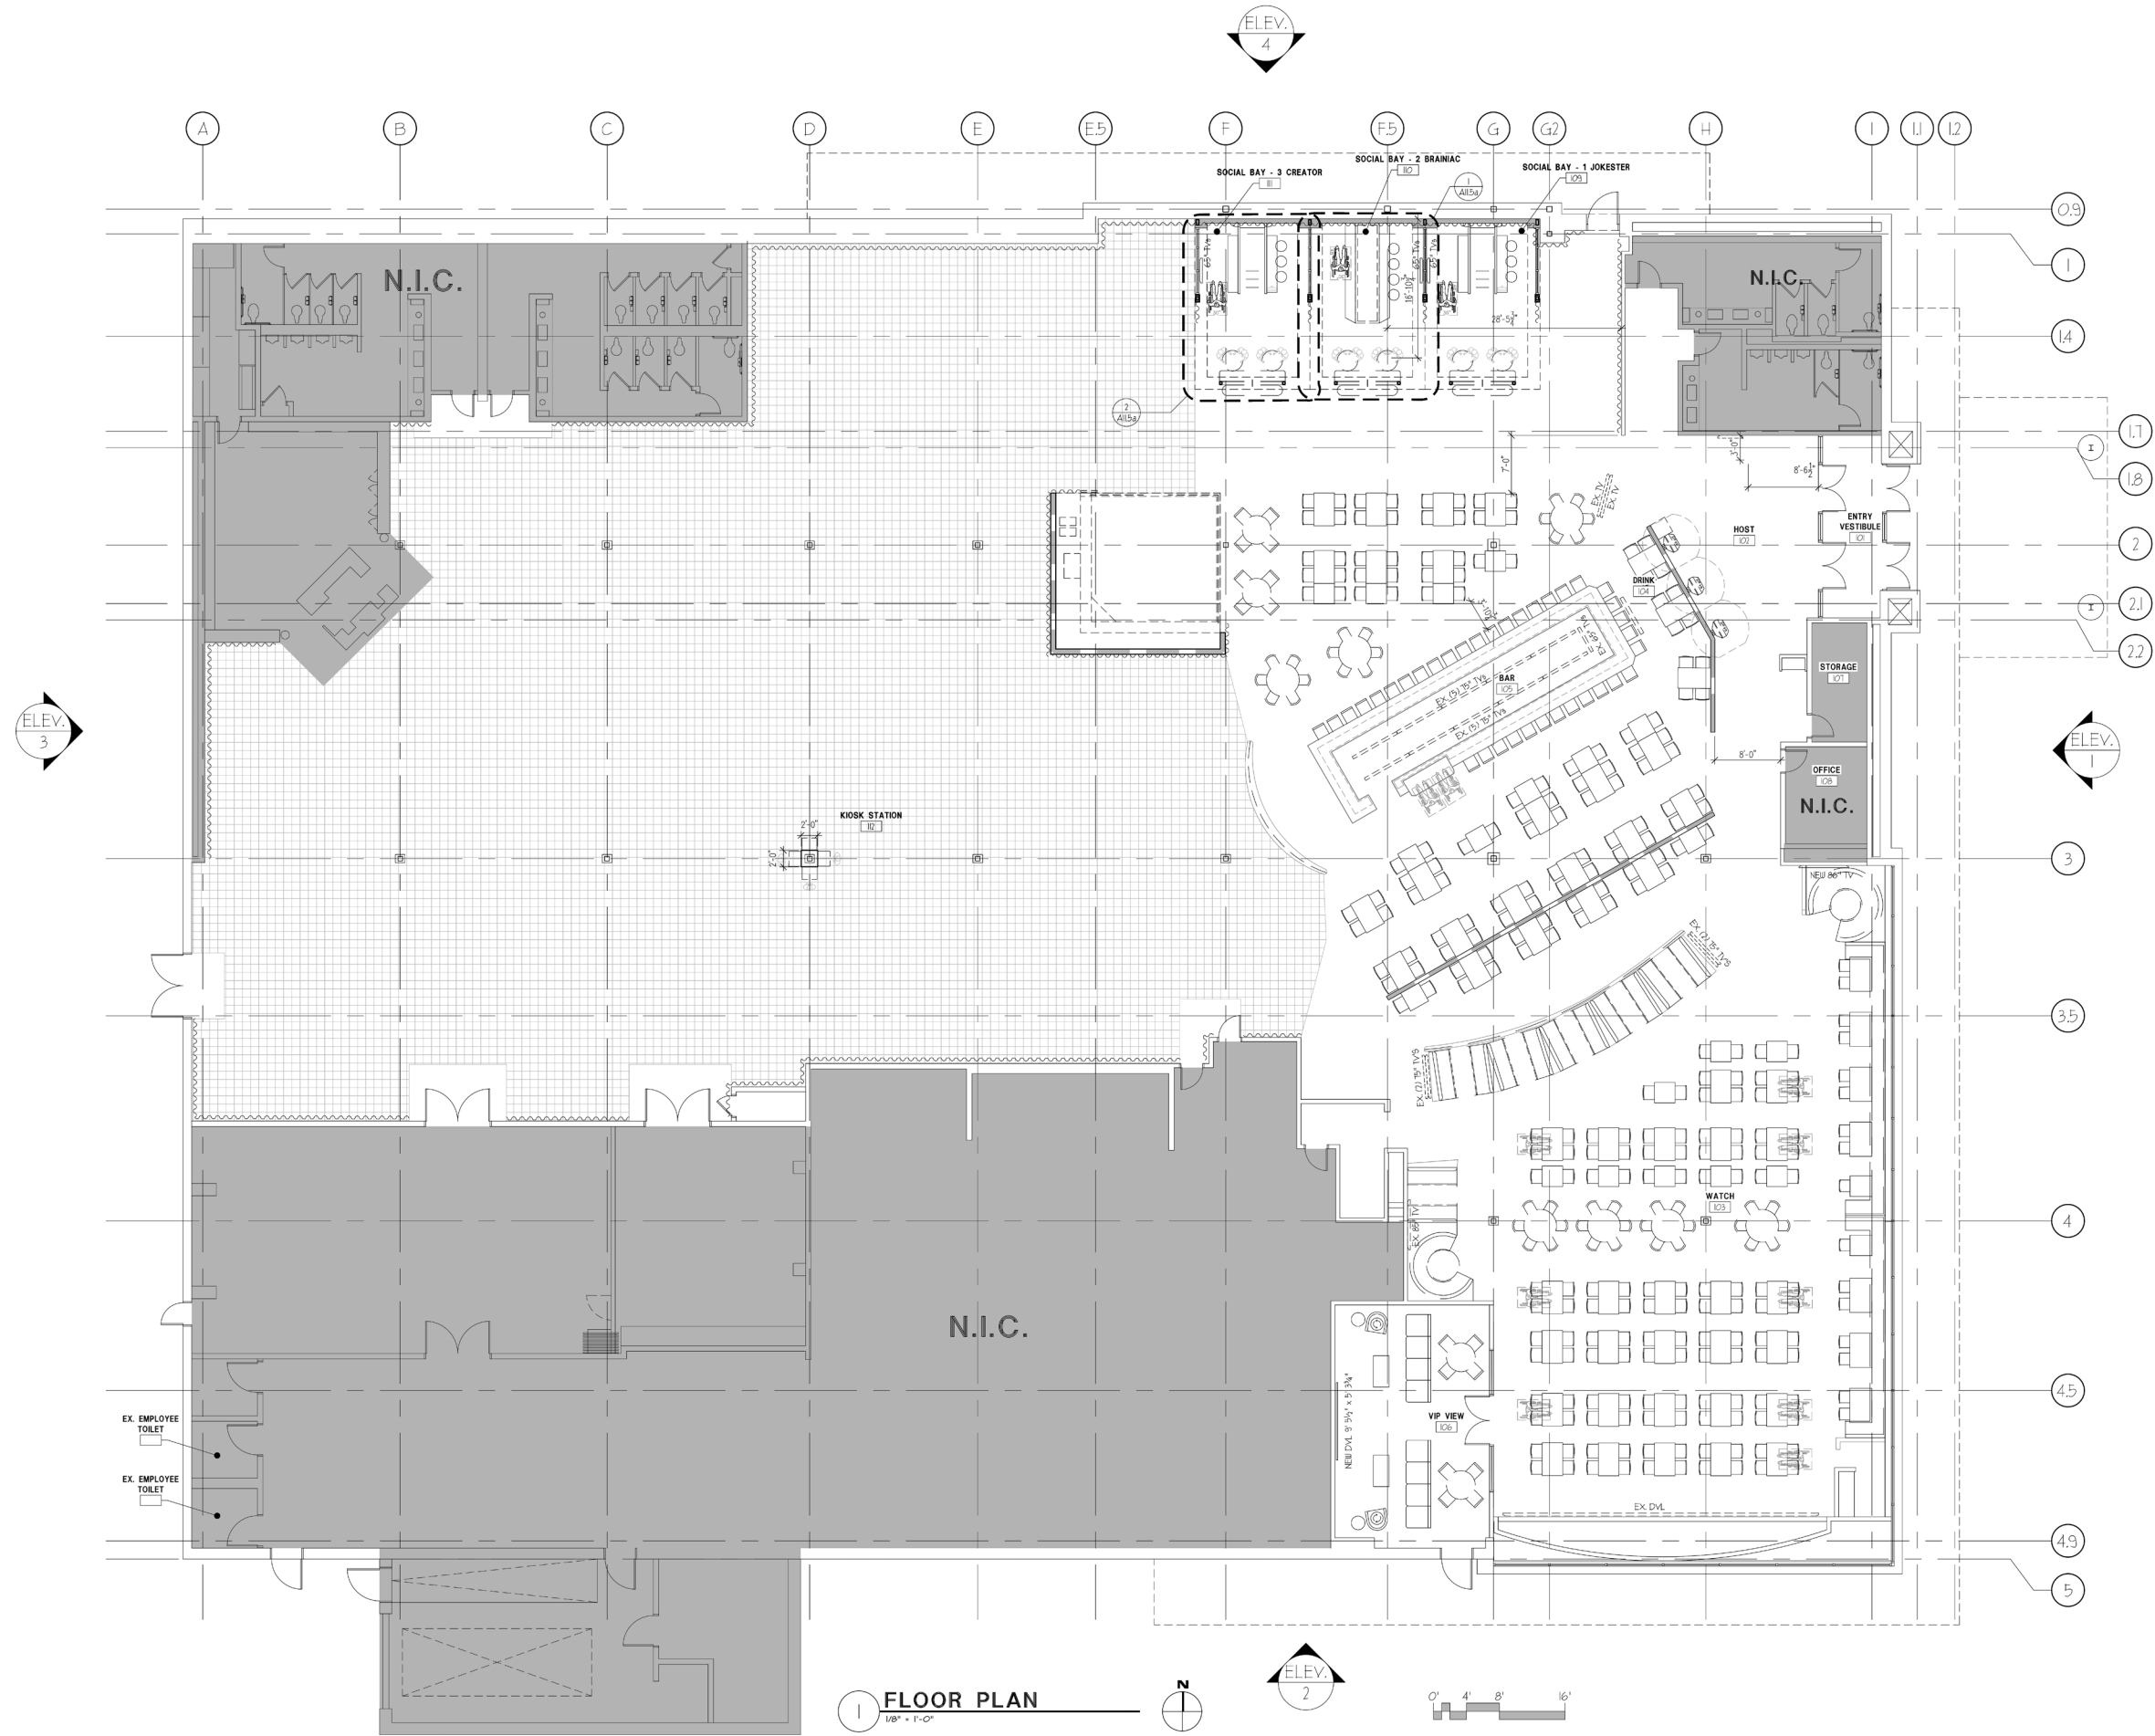

1 FLOOR PLAN
1/8" = 1'-0"

EXISTING & PROPOSED DESIGN

Wauwatosa, WI

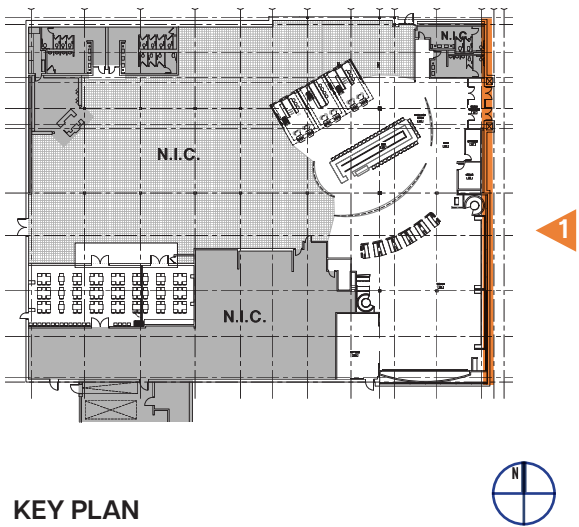


KEY PLAN




1 EXISTING EXTERIOR - EAST

PAINT RING
HONORABLE
BLUE

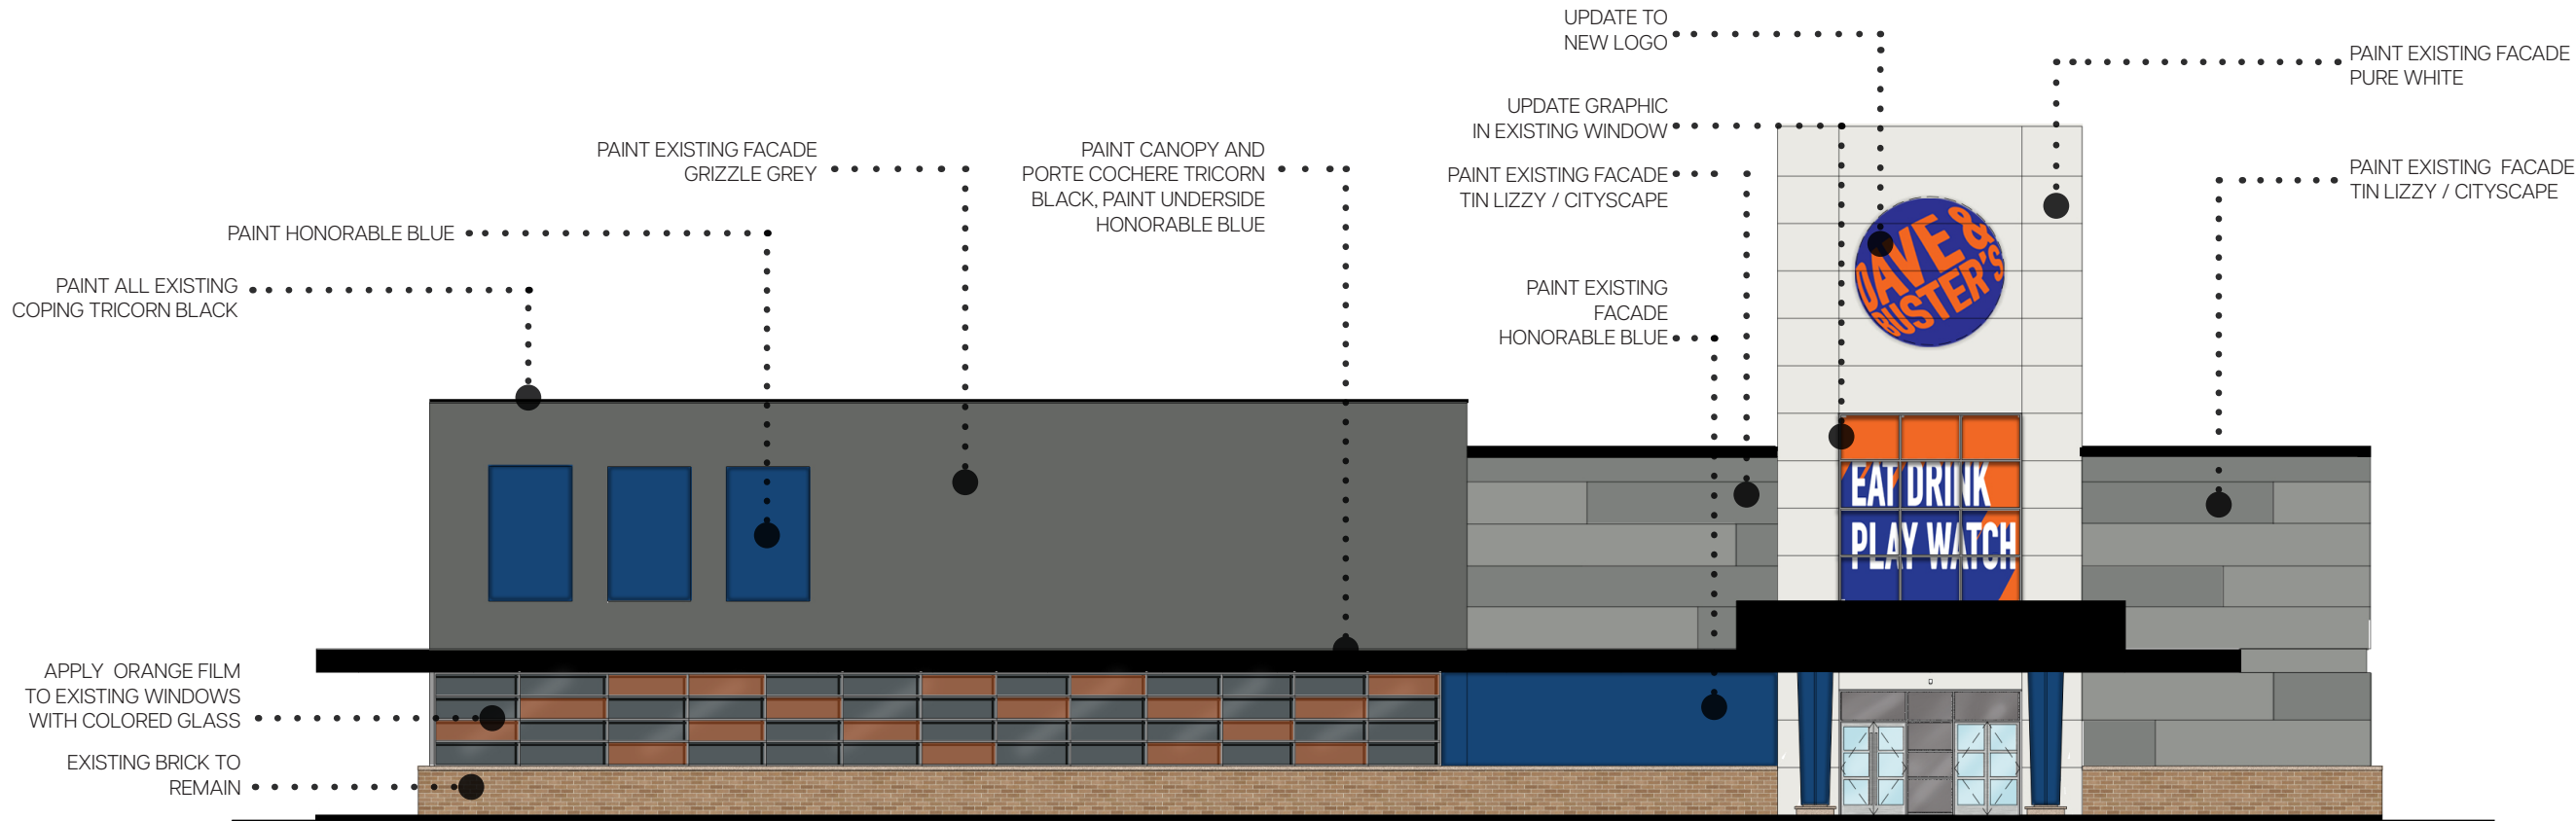


1 PROPOSED EXTERIOR- EAST

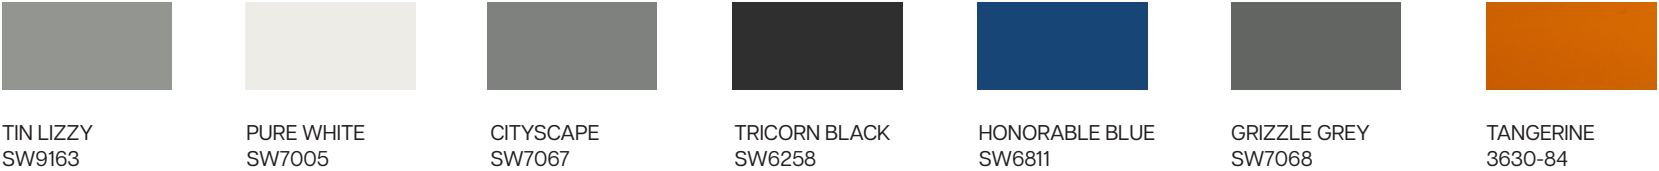


EXISTING & PROPOSED DESIGN


Wauwatosa, WI

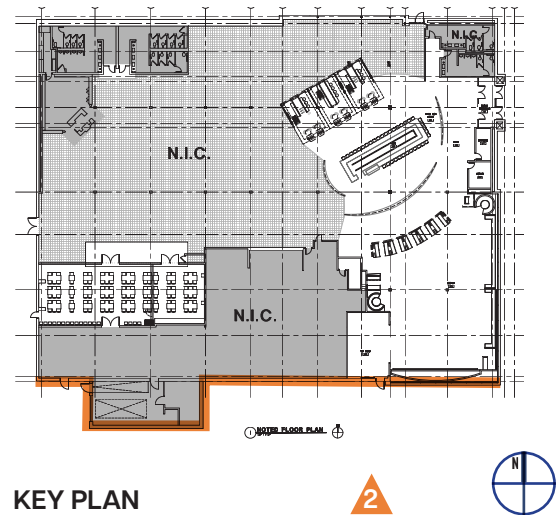

2 EXISTING EXTERIOR - SOUTH

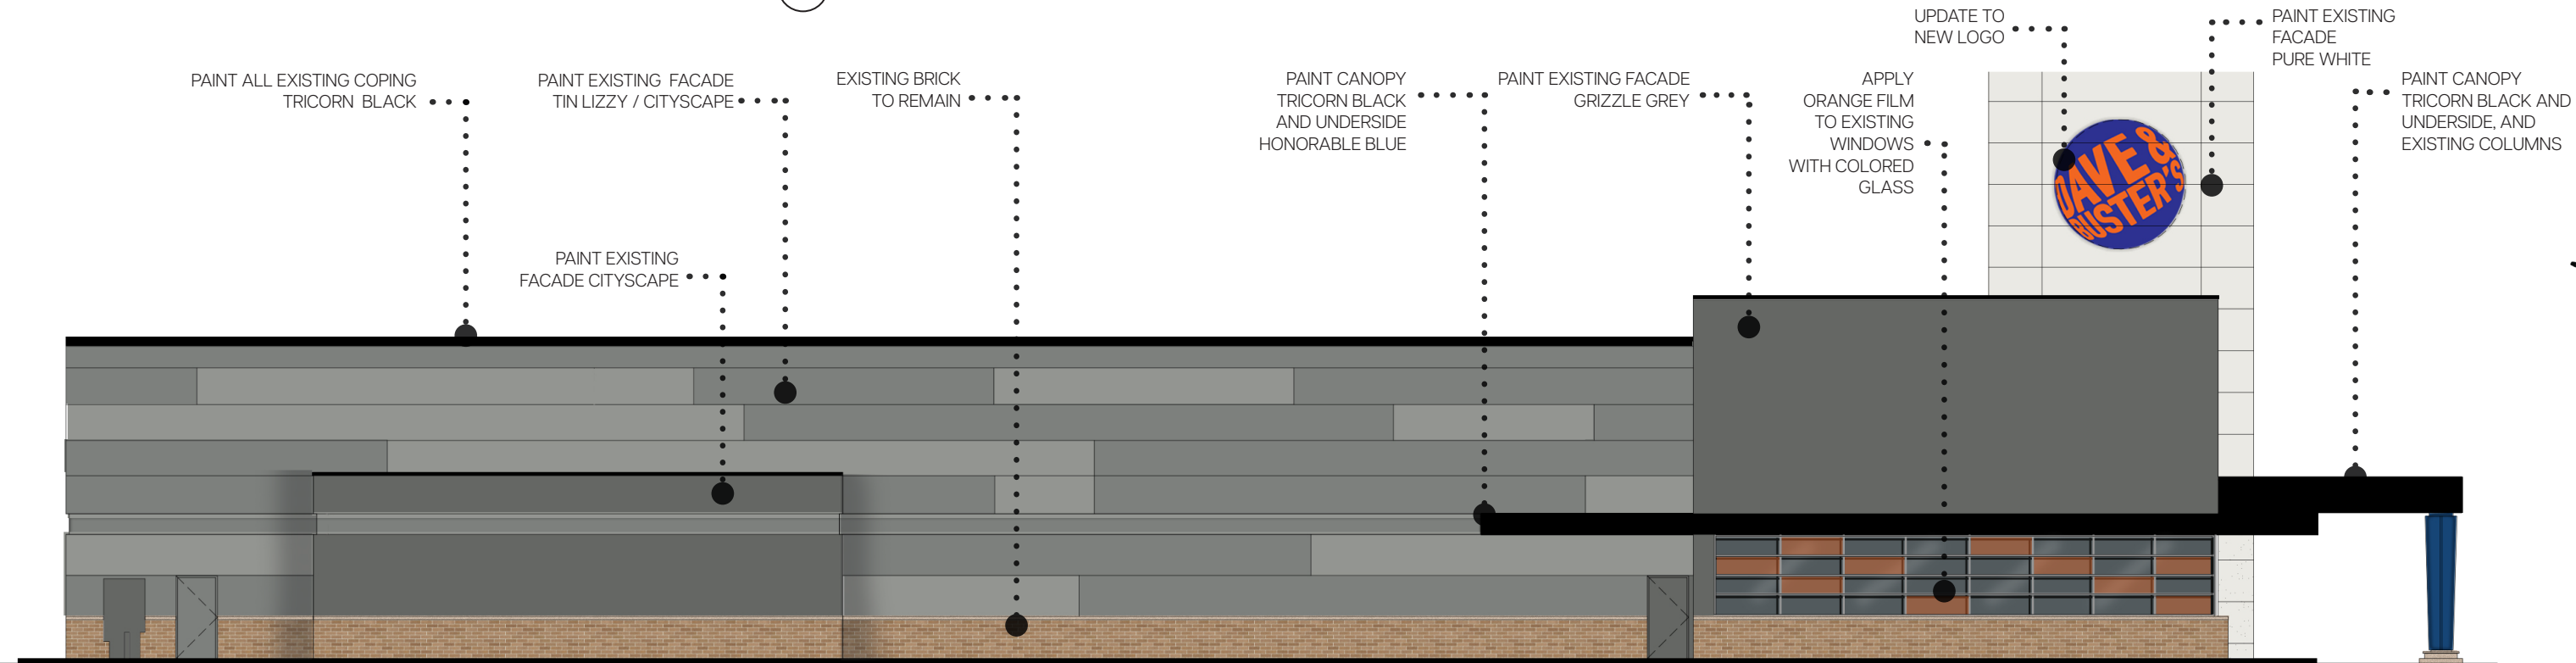


2 PROPOSED EXTERIOR- SOUTH

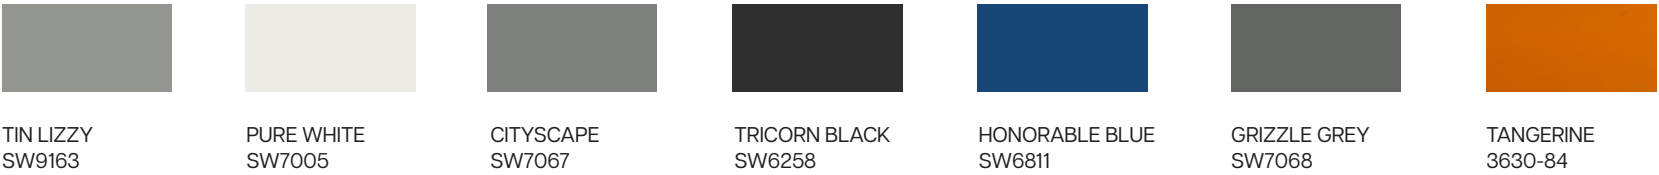


EXISTING & PROPOSED DESIGN

Wauwatosa, WI

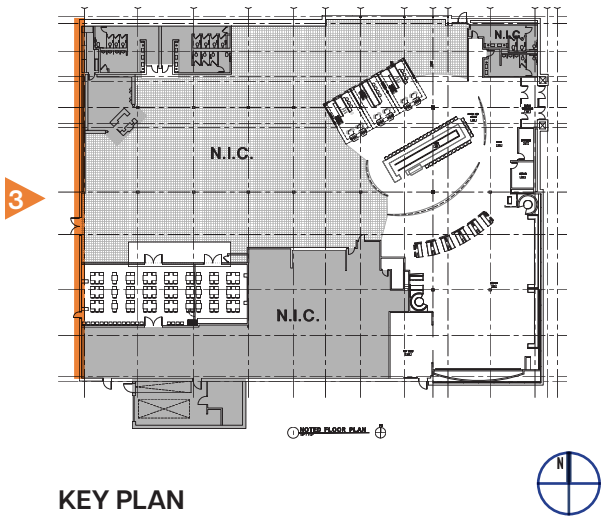

3 EXISTING EXTERIOR - WEST

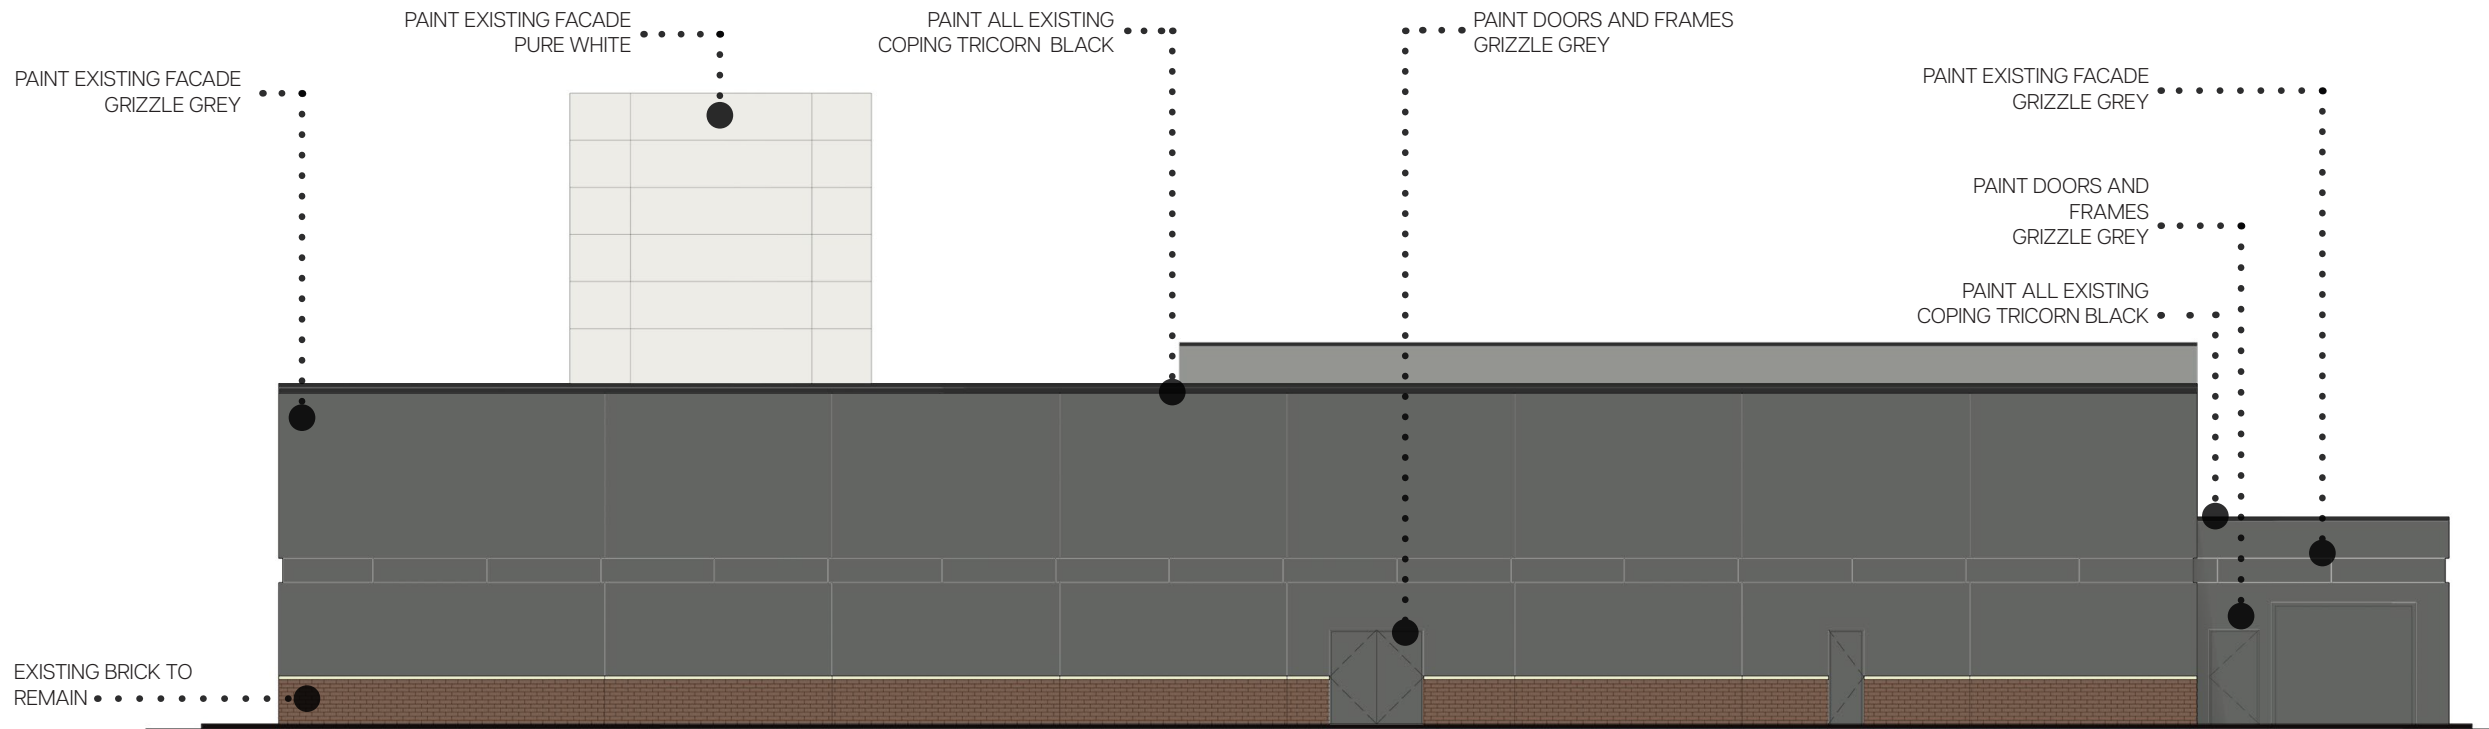


3 PROPOSED EXTERIOR- WEST



EXISTING & PROPOSED DESIGN


Wauwatosa, WI

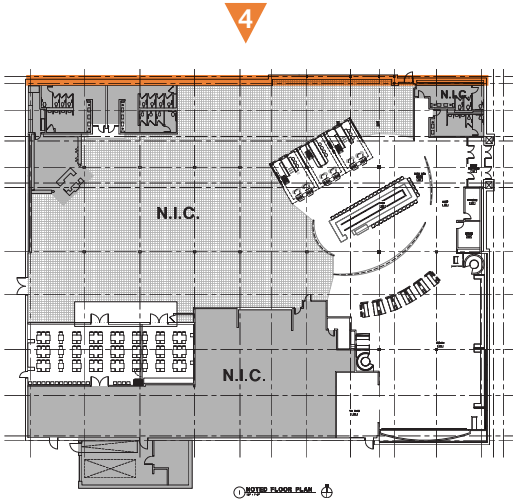

KEY PLAN



4 EXISTING EXTERIOR - NORTH

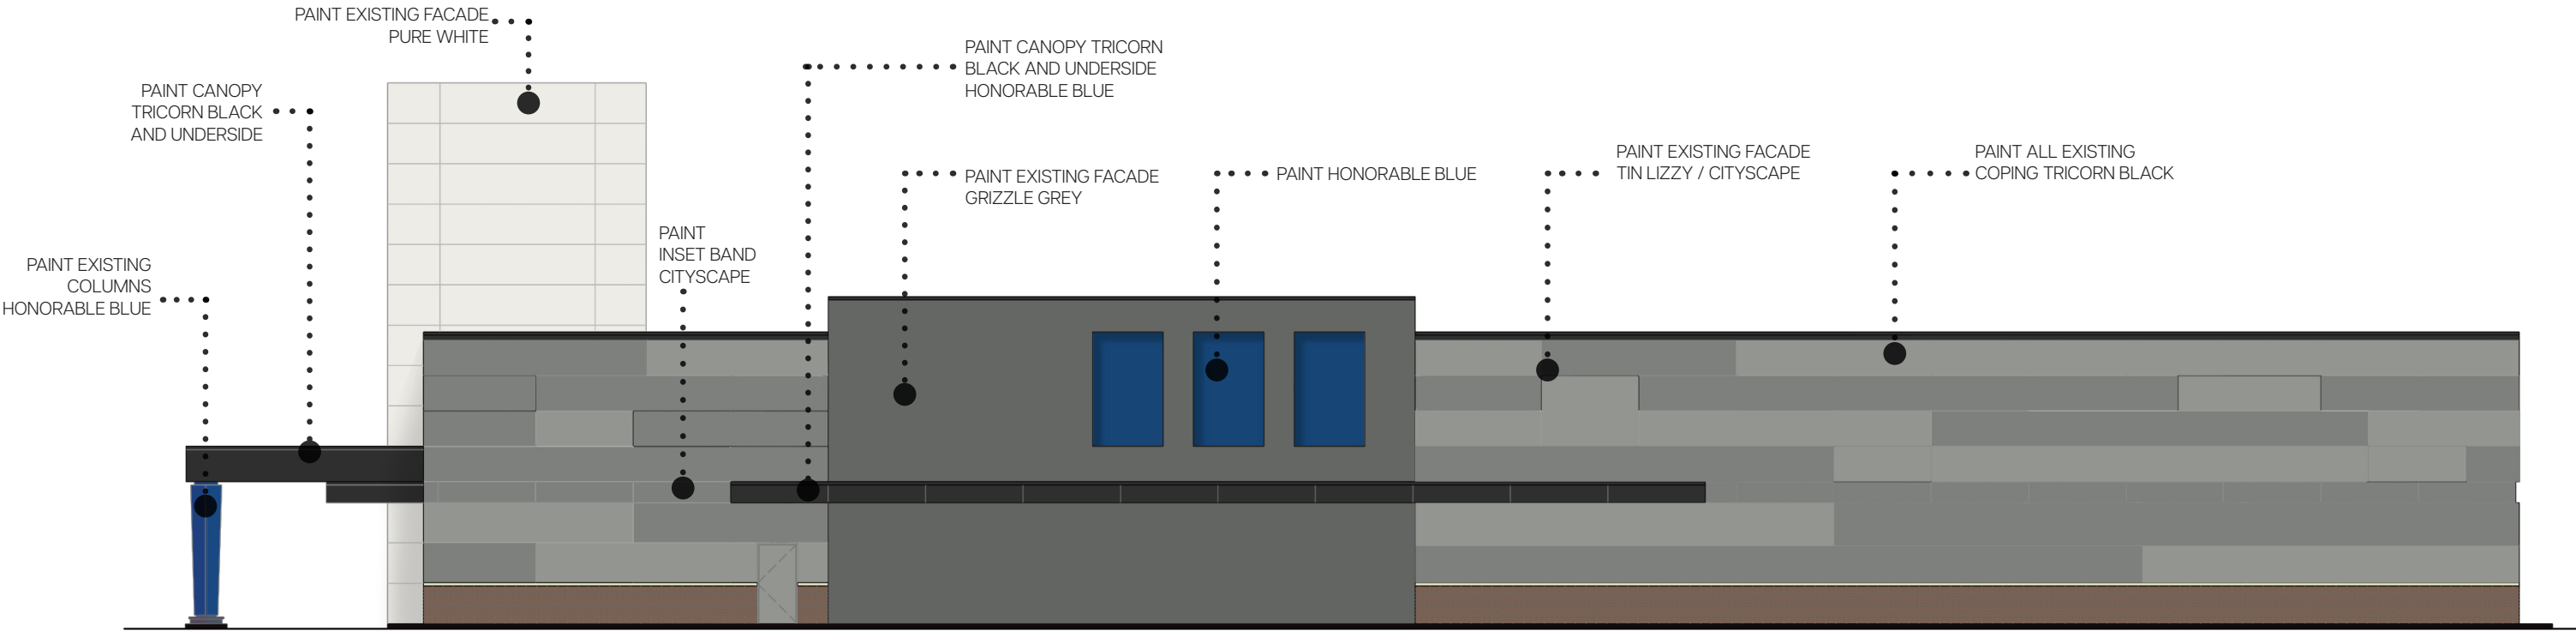

4 PROPOSED EXTERIOR- NORTH

TIN LIZZY SW9163	PURE WHITE SW7005	CITYSCAPE SW7067	TRICORN BLACK SW6258	HONORABLE BLUE SW6811	GRIZZLE GREY SW7068